

**TEST REPORT**

**Report No.:** B5023.01-701-44

**Rendered to:**

PRL ALUMINUM ARCHTECTURAL PRODUCTS  
City of Industry, California

**PRODUCT TYPE:** Aluminum Sliding Glass Door  
**SERIES/MODEL:** PRL Max Bottom Rolling Sliding Door "CANCUN"

**SPECIFICATION:** AAMA/WDMA/CSA 101/I.S.2/A440-08, *NAFS - North American Fenestration Standard/Specification for Windows, Doors, and Skylights*

<b>Summary of Results</b>		
<b>Title</b>	<b>Test Specimen #1</b>	<b>Test Specimen #2</b>
Primary Product Designator	Class CW-PG35-SD 2413 x 2108 (95x 83)	Class CW-PG45-SD 2413 x 2108 (95x 83)
Design Pressure	±2160 Pa (±45.11 psf)	-
Air Infiltration	0.61 L/s/m <sup>2</sup> (0.12 cfm/ft <sup>2</sup> )	-
Water Penetration Resistance Test Pressure	260 Pa (5.43 psf)	330 Pa (6.89 psf)

**Test Completion Date:** 12/13/2012

Reference must be made to Report No. B5023.01-701-44, dated 12/28/11 for complete test specimen description and detailed test results.

**1.0 Report Issued To:** PRL Aluminum Architectural Products  
14760 Don Julian Road  
City of Industry, California 91746

**2.0 Test Laboratory:** Architectural Testing, Inc.  
4 Rancho Circle  
Lake Forest, California 92630  
949.460.9600

**3.0 Project Summary:**

**3.1 Product Type:** Aluminum Sliding Glass Door

**3.2 Series/Model:** PRL Max Bottom Rolling Sliding Door "CANCUN"

**3.3 Compliance Statement:** Results obtained are tested values and were secured by using the designated test method. The specimens tested successfully met the performance requirements for the following ratings: Test Specimen #1: **Class CW-PG35-SD 2413 x 2108 (95 x 83)**; Test Specimen #2: **Class CW-PG45-SD 2413 x 2108 (95 x 83)**.

**3.4 Test Dates:** 11/16/2011 - 12/13/2011

**3.5 Test Location:** Architectural Testing's test facility in Lake Forest, California.

**3.6 Test Sample Source:** The test specimen was provided by the client. Representative samples of the test specimens will be retained by Architectural Testing for a minimum of four years from the test completion date.

**3.7 Drawing Reference:** The test specimen drawings have been reviewed by Architectural Testing and are representative of the test specimens reported herein. Test specimen construction was verified by Architectural Testing per the drawings located in Appendix B. Any deviations are documented herein or on the drawings.

**3.8 List of Official Observers:**

<u>Name</u>	<u>Company</u>
Frank Fisher	PRL Aluminum
John Mayfield	Architectural Testing, Inc.

**4.0 Test Specification(s):**

AAMA/WDMA/CSA 101/I.S.2/A440-08, *NAFS - North American Fenestration Standard/Specification for Windows, Doors, and Skylights*

## 5.0 Test Specimen Description:

### 5.1 Product Sizes:

Overall Area: 5.1 m <sup>2</sup> (54.8 ft <sup>2</sup> )	Width		Height	
	millimeters	inches	millimeters	inches
Overall size	2413	95	2108	83
Panel size	1226	48-1/4	2067	81-3/8

*Note: The following descriptions apply to all specimens.*

### 5.2 Frame Construction:

Frame Member	Material	Description
Head	Aluminum	Formed from custom shaped extruded aluminum.
Sill track (Threshold)	Aluminum	Secured to the upturned leg of the sub sill using a 3/8" wide x 1" long bead of sealant located at each end and 10" on center thereafter.
Sill track cover	Aluminum	Snapped into the exposed exterior sill track and fully sealed along each exterior joint and to the fixed interlocking stile.
Bottom rail fixed panel shoe	Aluminum	Inserted and secured into the bottom rail of the fixed panel using two rows of 3/8" wide double-sided tape and snapped into the sill track.
Sub sill <b>(Test Specimen #1)</b>	Aluminum	Bedded in sealant full length and fully sealed to each jamb member, measuring 1.562" high (P/N: BSP-02).
Sub sill (extender) <b>(Test Specimen #2)</b>	Aluminum	Bedded in sealant full length and fully sealed to each jamb member, measuring 1.860" high (P/N: BSP-03).
Jamb	Aluminum	Formed from custom shaped extruded aluminum.
Exterior jamb pocket cover	Aluminum	Snapped into the exterior jamb pocket of the strike jamb.
Interior jamb pocket cover	Aluminum	Snapped into the interior jamb pocket of the fixed panel.
Exterior head pocket cover	Aluminum	Snapped over the exterior channel of the head and sealed to the fixed interlock.

**5.0 Test Specimen Description: (Continued)**

	<b>Joinery Type</b>	<b>Detail</b>
Head/Jamb	Butted and sealed	Corners were butted and sealed full perimeter using sealant.
Sill track/jamb	Butted and sealed	Corners were butted and bedded in sealant and sealed full perimeter at the exterior.

**5.3 Panel Construction:**

<b>Fixed Panel Member</b>	<b>Material</b>	<b>Description</b>
Rails	Aluminum	Formed from custom shaped extruded aluminum members; sealed full length at the exterior to the head and sill track.
Stiles	Aluminum	Formed from custom shaped extruded aluminum members; sealed full length at the exterior to the jamb.

<b>Active Panel Member</b>	<b>Material</b>	<b>Description</b>
Rails	Aluminum	Custom shaped extruded aluminum
Stiles	Aluminum	Custom shaped extruded aluminum

	<b>Joinery Type</b>	<b>Detail</b>
Rail/Stile	Butted	Members were butted and secured using a custom-shaped aluminum L-shaped bracket that was secured through the glazing pocket of the rail member using two #10 x1" sheet metal screws and secured to the stile using a #10 x 3/4" socket head cap bolt with a #10 lock nut.

**5.0 Test Specimen Description: (Continued)**

**5.4 Weatherstripping:**

Description	Quantity	Location
0.320" x 0.270 pile w/fin	4 Rows	Sill track guide at each exterior panel face
0.320" x 0.270 pile w/fin	4 Rows	Interior and exterior facing legs of the exterior sill track
0.320" x 0.270 pile w/fin	2 Rows	Jamb face of the lock stile
0.290" x 0.270 pile w/fin	1 Row	Interior leg of the interior jamb pocket
0.290" x 0.270 pile w/fin	1 Row	Exterior leg of the interior jamb pocket
0.320" x 0.270 pile w/fin	2 Rows	Jamb face of the fixed stile
0.290" x 0.270 pile w/fin	1 Row	Exterior leg of the exterior jamb pocket
0.290" x 0.270 pile w/fin	1 Row	Interior leg of the exterior jamb pocket
0.320" x 0.270 pile w/fin	2 Rows	Interior face of the fixed interlock stile
2" x 2" x 0.290" adhesive-backed pile	1 Plug	Adhered to the sill track below the interlock of the active panel
2" x 2" x 1" open cell foam	1 Plug	Fully sealed into the top hollow of the fixed interlock extrusion
0.290" x 0.270 pile w/fin	2 Rows	Exterior face of the interlocking stile of the active panel

**5.5 Glazing:**

Glass Type	Spacer Type	Interior Lite	Exterior Lite	Glazing Method
1-1/8" IG	Aluminum box	1/4" Tempered	1/4" Tempered	Marine glazed into a rubber glazing gasket

Location	Quantity	Daylight Opening		Glass Bite
		millimeters	inches	
Fixed panel	1	1073 x 1889	42-1/4 x 74-3/8	0.625"
Active panel	1	1073 x 1889	42-1/4 x 74-3/8	0.625"

**5.0 Test Specimen Description:** (Continued)

**5.6 Drainage:**

Drainage Method	Size	Quantity	Location
Weep slot	1/2" wide x 1/4" high	2 per panel	12" on center from the stiles of each panel; cut through the exterior sill face continuing through each leg of the sill track

**5.7 Hardware:**

Description	Quantity	Location
Roller assembly	2	Inserted into each end of the bottom rail and secured to each stile and the bottom rail using two #1/4-20 x 1" machine screws
Stainless steel track cover	1	Snapped over the interior roller track
Adams-Rite lock set	1	Located at the midpoint of the stile

**5.8 Reinforcement:** No reinforcement was utilized.

**5.9 Screen Construction:** No screen was utilized.

**6.0 Installation:**

The specimen was installed into a 2x10 aluminum test buck. The sub sill was bedded in sealant and the exterior perimeter of the door was sealed with sealant.

Location	Anchor Description	Anchor Location
Jambs	One 1/4-20 x 1-1/2" Phillips flat head screw	4" on center from the head and sill and 12" on center thereafter; through the interior jamb pocket
Jambs	One 1/4-20 x 1-1/2" Phillips pan head screw	4" on center from the head and sill and 12" on center thereafter; through the interior jamb pocket
Threshold	Four #10 x 3/4" Phillips pan head sheet metal screws (one though each channel of the track)	Located at 4" and 6" on center from each end and at the midpoint
Head	Two 1/4-20 x 3/4" Phillips pan head screws	4" on center from the ends and 12" on center thereafter through interior and exterior channel of the head

**7.0 Test Results:** The temperature during testing was 14°C (58°F). The results are tabulated as follows:

**Test Specimen #1:**

<b>Title of Test</b>	<b>Results</b>	<b>Allowed</b>	<b>Note</b>
<b>Operating Force,</b> per ASTM E 2068	Initiate motion: 57.9 N (19 lbf) Maintain motion: 31.1 N (14 lbf) Lock: 17.8 N (4 lbf)	135.0 N (40 lbf) max. 90.0 N (25 lbf) max. 100.0 N (22.5 lbf) max.	
<b>Air Leakage,</b> Infiltration per ASTM E 283 at 75 Pa (1.57 psf)	0.61 L/s/m <sup>2</sup> (0.12 cfm/ft <sup>2</sup> )	1.5 L/s/m <sup>2</sup> (0.3 cfm/ft <sup>2</sup> ) max.	1
<b>Water Penetration,</b> per ASTM E 547 at 260 Pa (5.43 psf)	Pass	No leakage	2
<b>Uniform Load Deflection,</b> per ASTM E 330 taken on the fixed interlock stile +1680 Pa (+35.09 psf) -1680 Pa (-35.09 psf)	8.1 mm (0.32") 8.6 mm (0.34")	11.9 mm (0.47") 11.9 mm (0.47")	3, 4
<b>Uniform Load Structural,</b> per ASTM E 330 taken on the fixed interlock stile +2520 Pa (+52.63 psf) -2520 Pa (-52.63 psf)	0.2 mm (0.01") 0.2 mm (0.01")	8.1 mm (0.32") max. 8.1 mm (0.32") max.	3, 4
<b>Forced Entry Resistance,</b> per ASTM F 842, Type: A - Grade: 10	Pass	No entry	
<b>Deglazing,</b> per ASTM E 987 Operating direction, 320 N (70 lbf)	Pass	Meets as stated	
Remaining direction, 230 N (50 lbf)	Pass	Meets as stated	

**7.0 Test Results:** (Continued)

**Test Specimen #1:**

<b>Optional Performance</b>			
<b>Uniform Load Deflection,</b> per ASTM E 330 taken on the fixed interlock stile +2160 Pa (+45.11 psf) -2160 Pa (-45.11 psf)	9.9 mm (0.39") 11.2 mm (0.44")	11.9 mm (0.47") 11.9 mm (0.47")	3, 4
<b>Uniform Load Structural,</b> per ASTM E 330 taken on the fixed interlock stile +3240 Pa (+67.67 psf) -3240 Pa (-67.67 psf)	0.2 mm (0.01") 0.2 mm (0.01")	8.1 mm (0.32") max. 8.1 mm (0.32") max.	3, 4

**Test Specimen #2:**

<b>Optional Performance</b>			
<b>Water Penetration,</b> per ASTM E 547 at 330 Pa (6.89 psf)	Pass	No leakage	2

*Note 1: The tested specimen meets (or exceeds) the performance levels specified in AAMA/WDMA/CSA 101/I.S.2/A440 for air leakage resistance.*

*Note 2: Without insect screen.*

*Note 3: Loads were held for 10 seconds.*

*Note 4: Tape and film were not used to seal against air leakage during structural testing.*



The service life of this report will expire on the stated Test Record Retention End Date, at which time such materials as drawings, data sheets, samples of test specimens, copies of this report, and any other pertinent project documentation, shall be discarded without notice.

If test specimen contains glazing, no conclusions of any kind regarding the adequacy or inadequacy of the glass in any glazed test specimen(s) can be made. This report does not constitute certification of this product nor an opinion or endorsement by this laboratory. It is the exclusive property of the client so named herein and relates only to the specimen(s) tested. This report may not be reproduced, except in full, without the written approval of Architectural Testing, Inc.

For ARCHITECTURAL TESTING, Inc.

---

John S. Mayfield  
Project Manager

---

Shawn G. Collins, P.E.  
Laboratory Support Engineer

JM:bu/cmd

Attachments (pages): This report is complete only when all attachments listed are included.

Appendix-A: Alteration Addendum (1)

Appendix-B: Drawings (18)

## **Appendix A**

### **Alteration Addendum**

**Alteration #1:** Date - 11/17/2011  
Cause for alteration - Water infiltration over the sill  
Remedial action taken - Replaced sub sill with a 1.562" high sill leg

Test Report No.: B5023.01-701-44  
Report Date: 12/28/11  
Test Record Retention End Date: 12/13/15

## **Appendix B**

### **Drawings**

# PRL Max sliding door "CANCUN"

## Bill of Material

key number	PRL part number	manufacturer	description	qty required	size
1	2263	PRL proprietary	top frame rail	1	W
2	2204	PRL proprietary	sash top rail	2	(W/2)- 5 1/16"
3a	BSP-02	PRL proprietary	sub sill CW-35 rating	1	W
3b	BSP-03	PRL proprietary	sub sill CW-45 rating	1	W
4	2205	PRL proprietary	bottom sash rails	2	(W/2)- 5 1/16"
5	2259	PRL proprietary	sill track	1	W- 1 3/8"
6	2261	PRL proprietary	frame jamb	2	H- 2 1/16"
7	2201	PRL proprietary	sash lock/jamb stile	2	H-1 9/16"
8	2237	PRL proprietary	sash interlock stiles	2	H-1 9/16"
9	2197	PRL proprietary	frame jamb closer	2	H-1"
10	2249	PRL proprietary	non operating leaf support shoe	2	6"
11	29027045BKQB	Amesbury	fin seal 0.290 x 0.270 base (typ horizontally)	8	W
11	29027045BKQB	Amesbury	fin seal 0.290 x 0.270 base (typ vertically)	12	H
12	BL-4514	bandlock	glazing channel	2	(4*H)+(2*W)
13	shg-47	Hagg supply	stainless steel track guide cover (0.031)	1	W- 1 3/8"
21		PRL proprietary	roller wheels	2	as drawn
			insulated glass width	2	(W/2)- 3 3/4"
			insulated glass height	2	H-8 5/16"
			Adams Rite MS-1850 lock	1	




**Architectural Testing**

Test sample complies with these details.  
Deviations are noted.

Report# B5623.01  
Date 12/15 Tech [Signature]

# max sliding door "CANCUN"

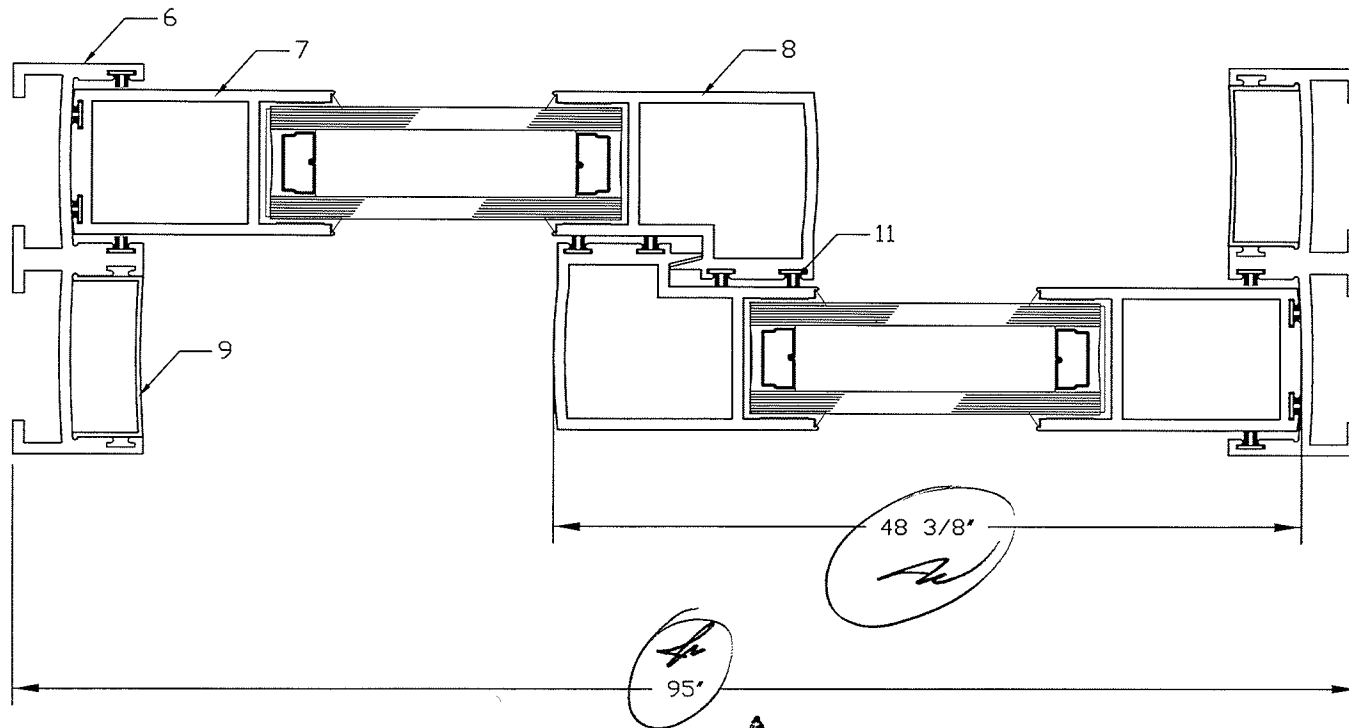

 Architectural Testing

Test sample complies with these details.  
Deviations are noted.

Report# B5023.01  
Date 12/16 Tech Ac

**PRL**   
ALUMINUM INC.


# max sliding door "CANCUN"



Architectural Testing

Test sample complies with these details.  
Deviations are noted.

Report# B5023.01  
Date 12/15 Tech [Signature]

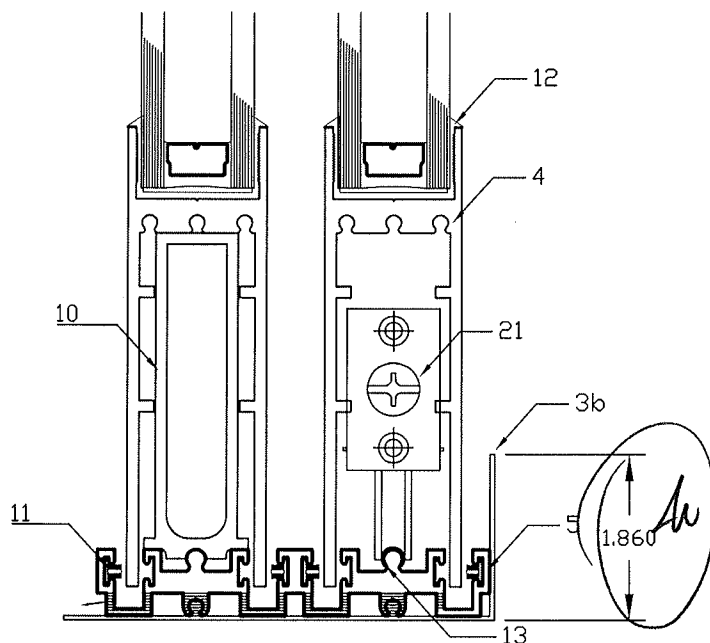

part's #5  
have 2 weep  
holes per light  
1/2" wide.

sill detail for CW-45 rating

**PRL**   
ALUMINUM INC.

# max sliding door "CANCUN"




Architectural Testing

Test sample complies with these details.  
Deviations are noted.

Report# B5023.01

Date 12/15 Tech [Signature]

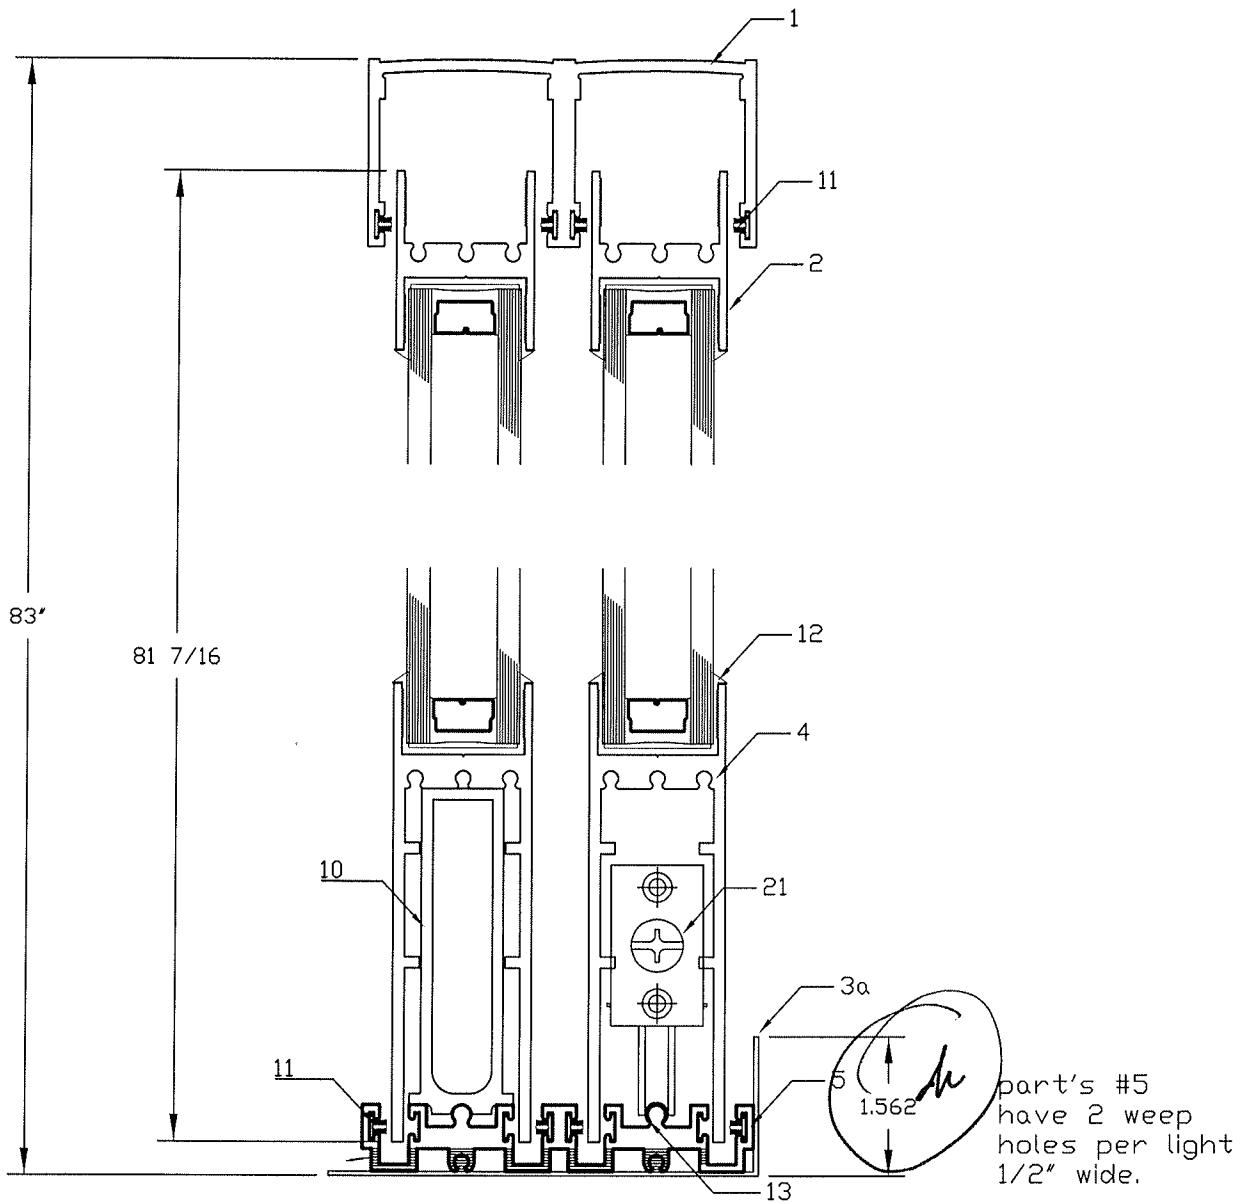


sill detail for CW-35 rating

**PRL**   
ALUMINUM INC.

UNLESS OTHERWISE SPECIFIED STANDAR  
ALUMINUM ASSOCIATION TOLERANCES APPLY

DIE NO. 2259

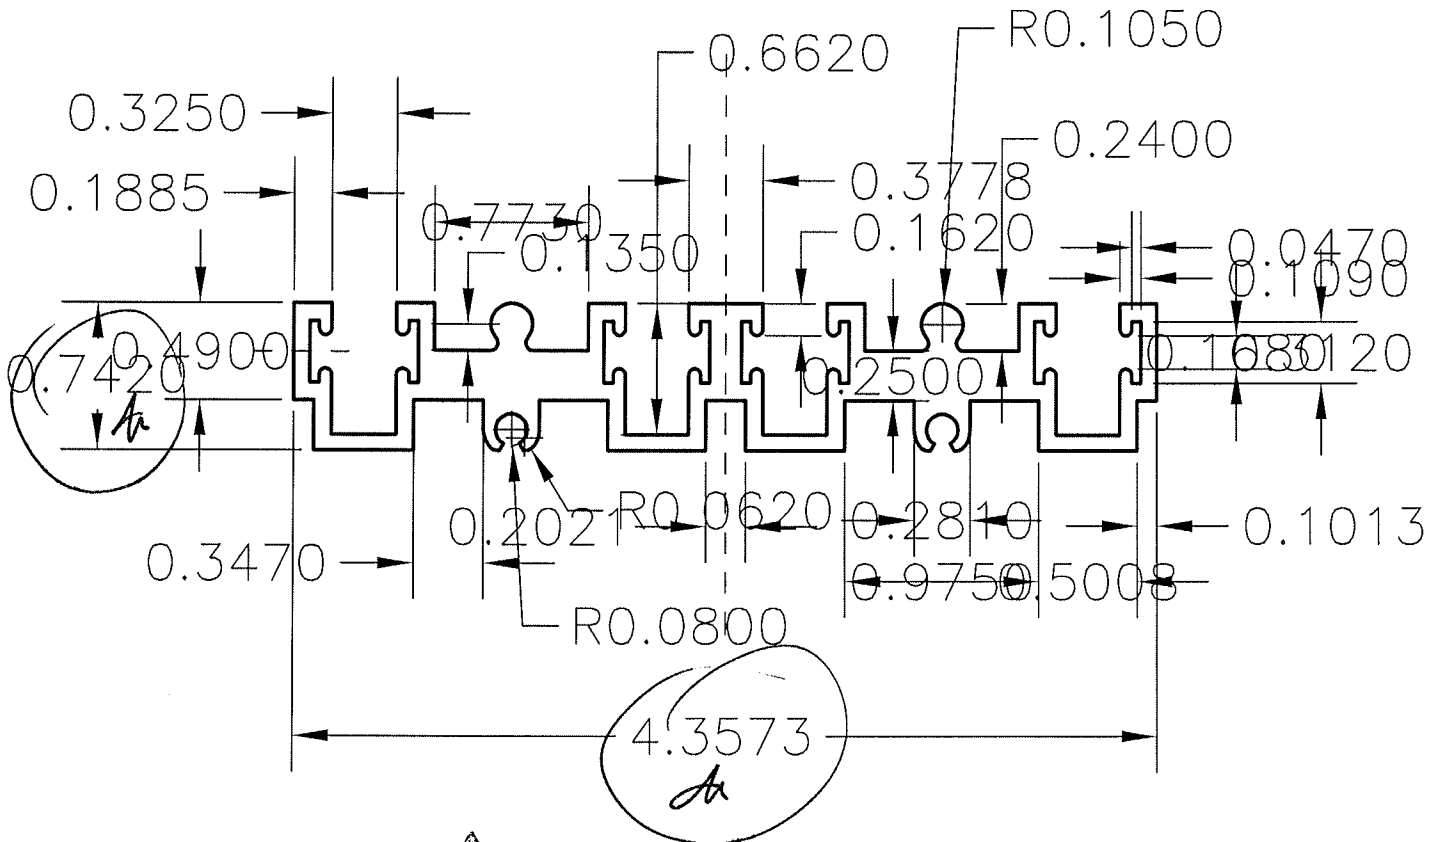

Test sample complies with these details.  
Deviations are noted.

Report# B5023.01  
Date 12/15 Tech [Signature]

UNLESS OTHER WISE NOTED .080 TYP. WALL ALL UNMARK CORNER ARE 0.010

REVISION	CUSTOMER:		
MAT.'L	6063-T5	HOLES	* CRITICAL DIM.
AREA	1.372	BACKER	⊗ SPECIAL TOOL
WT. / FT	11.646	BOLSTER	DRAWN: AJ
PERI.	24.10	W/P	DATE: 7/22/10
FACTOR	14.47	EXT. RATIO	PART NAME:
C.C.D.	CLASS Solid	SCALE FULL	PART #


**PRL**  
ALUMINUM INC.  
14760 DON JULIAN RD.  
INDUSTRY CA. 91746  
TEL. ( 877 ) 775-2586  
PRL-ALUM  
FAX ( 877 ) 274-8800




part NO. **BSP-03**

**Architectural Testing**  
 Test sample complies with these details.  
 Deviations are noted.

Report# B5023.01  
 Date 1/15 Tech [Signature]  
 TEST SPECIMEN # 2

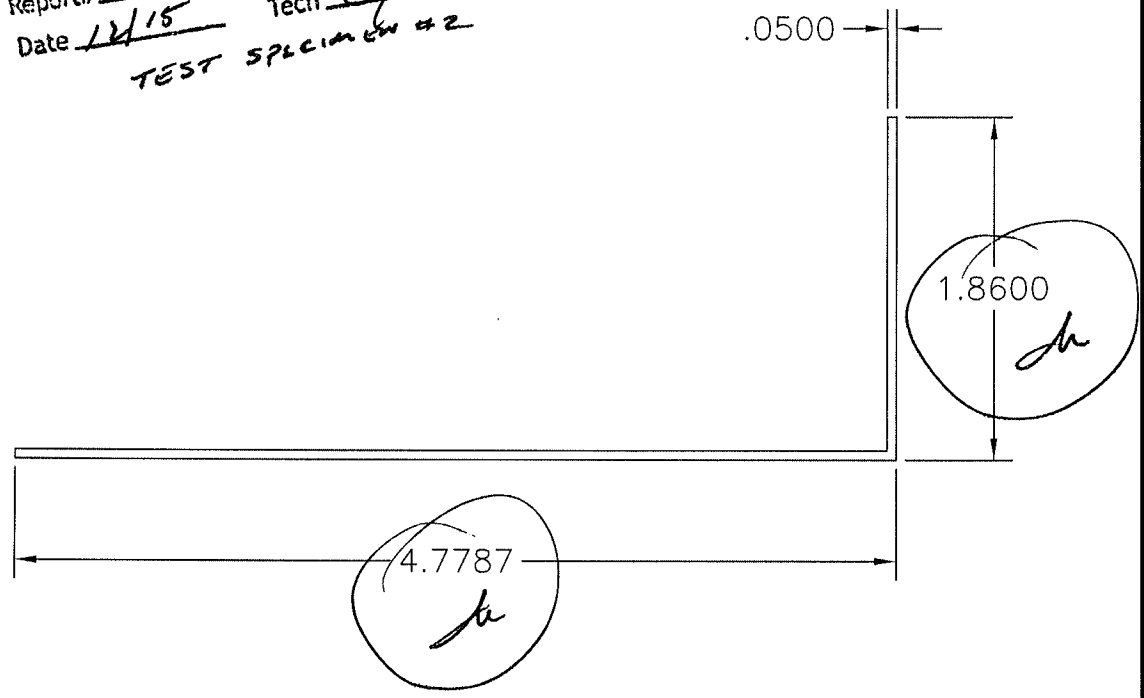

REVISION	CUSTOMER: - <b>PRL</b>		
MAT. L	HOLES	* CRITICAL DIM. ⊗ SPECIAL TOOL	
AREA	BACKER		
WT. / FT	BOLSTER	DRAWN:	
PERI.	W/P		
FACTOR	EXT. RATIO	DATE:	
C.C.D.	CLASS Hollow	SCALE 1:1	

**PRL**   
**ALUMINUM INC.**  
 14760 DON JULIAN RD.  
 INDUSTRY CA. 91746  
 TEL. ( 877 ) 775-2586  
 PRL-ALUM  
 FAX ( 877 ) 274-8800

PART NAME:  
 PART #


part NO. **BSP-02**



**Architectural Testing**

Test sample complies with these details.  
Deviations are noted.

Report# B5023.01  
Date 12/15 Tech [Signature]

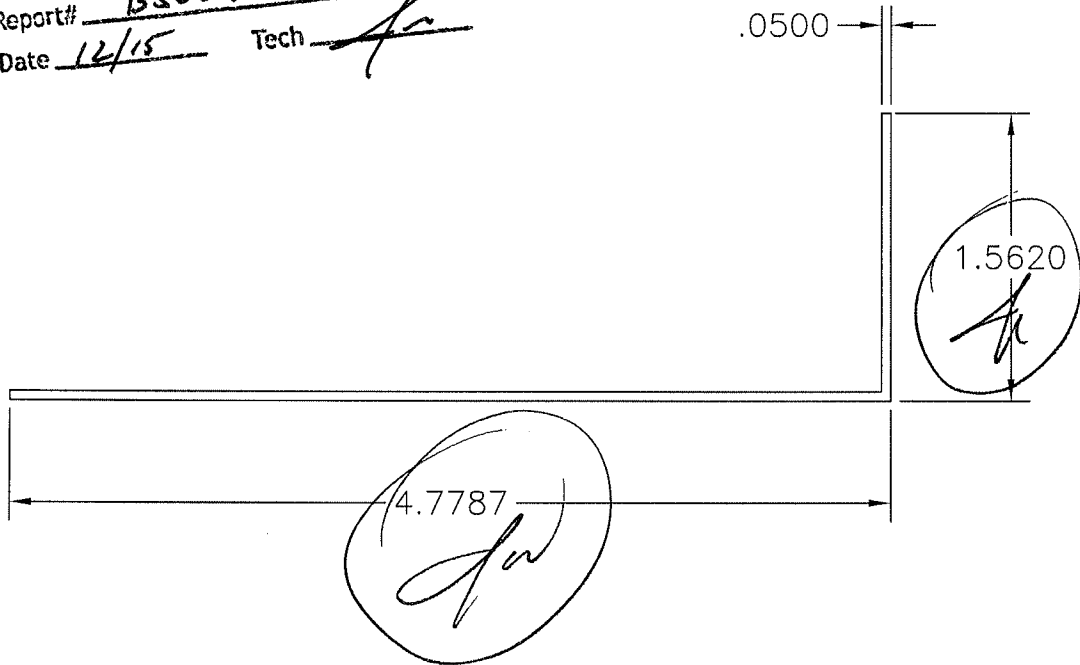

REVISION

CUSTOMER: - **PRL**

**PRL**  
**ALUMINUM INC.**

14760 DON JULIAN RD.

INDUSTRY CA. 91746

TEL. ( 877 ) 775-2586

PRL-ALUM

FAX ( 877 ) 274-8800

MAT. L	HOLES	* CRITICAL DIM. ⊗ SPECIAL TOOL
AREA	BACKER	
WT. / FT	BOLSTER	
PERI.	W/P	
FACTOR	EXT. RATIO	DRAWN:
C.C.D.	CLASS Hollow	DATE:
		SCALE 1:1

PART NAME:

PART #

DIE NO. 2263



UNLESS OTHERWISE SPECIFIED STANDAR ALUMINUM ASSOCIATION TOLERANCES APPLY



**Architectural Testing**

Test sample complies with these details.  
Deviations are noted.

Report# B5023.01  
Date 12/15 Tech [Signature]

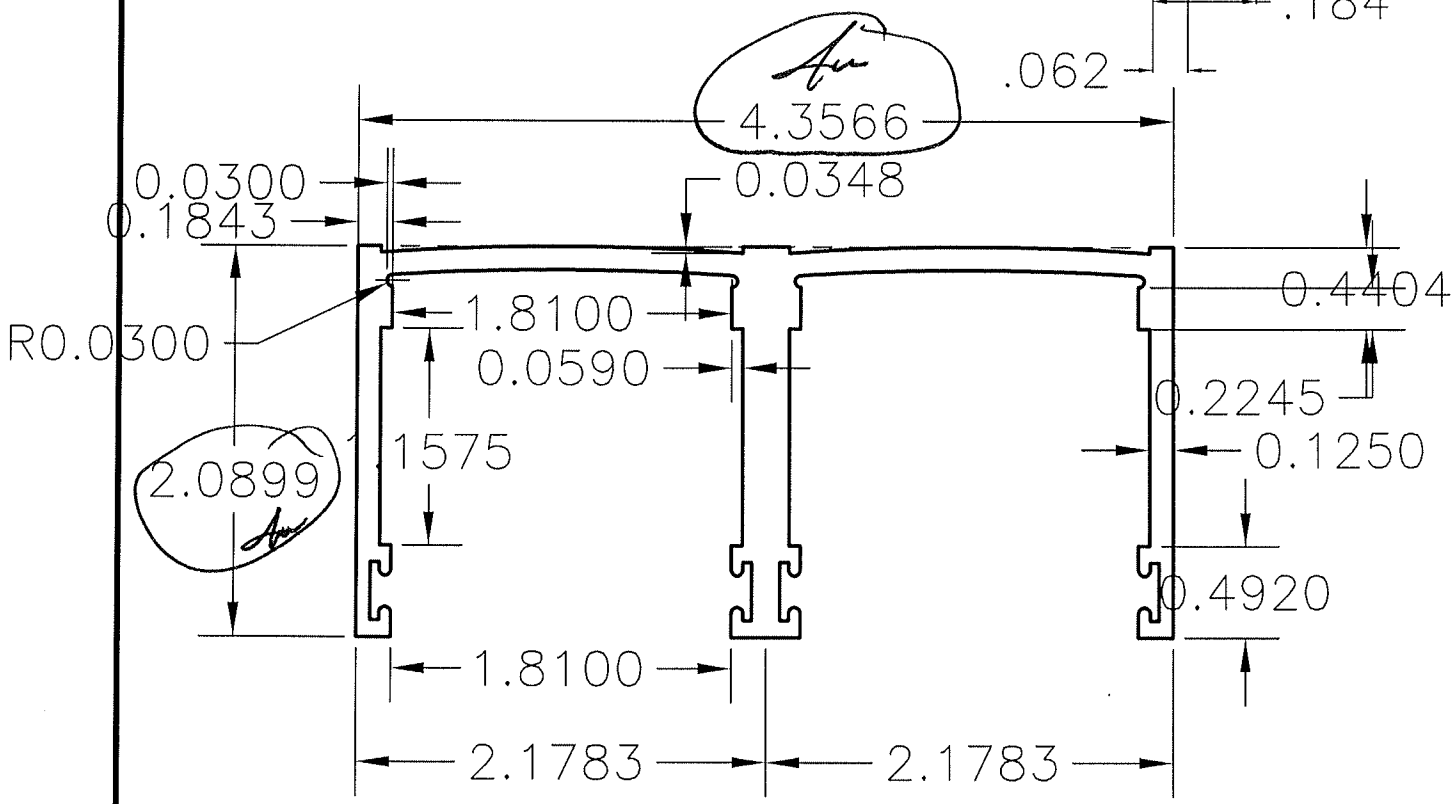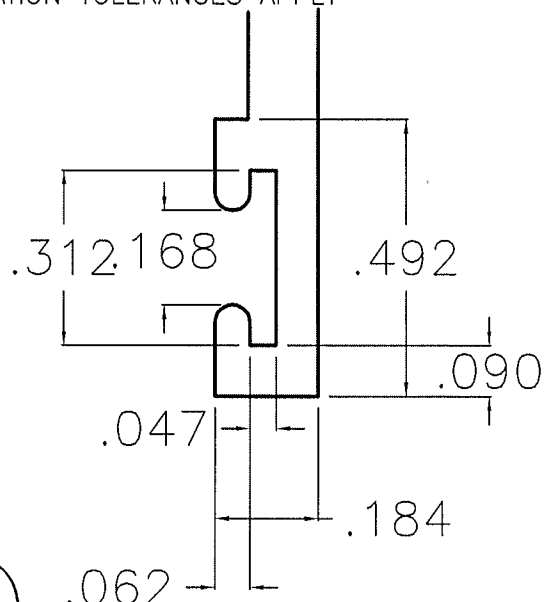

UNLESS OTHER WISE NOTED .125 TYP. WALL ALL UNMARK CORNER ARE 0.010

REVISION	CUSTOMER:		
	MAT. L	6063-T5	HOLES
	AREA	1.60	BACKER
	WT. / FT	1.92	BOLSTER
	PERI.	23.20	W/P
FACTOR	14.32	EXT. RATIO	* CRITICAL DIM.
C.C.D.	CLASS Solid	SCALE 1 : 1	⊗ SPECIAL TOOL

**PRL**



**ALUMINUM INC.**  
14760 DON JULIAN RD.  
INDUSTRY CA. 91746  
TEL. ( 877 ) 775-2586  
PRL-ALUM  
FAX ( 877 ) 274-8800

PART NAME:  
PART #

DIE NO. 2261

UNLESS OTHERWISE SPECIFIED STANDAR ALUMINUM ASSOCIATION TOLERANCES APPLY

**Architectural Testing**  
 Test sample complies with these details.  
 Deviations are noted.  
 Report# B5023.01  
 Date 12/15 Tech. [Signature]

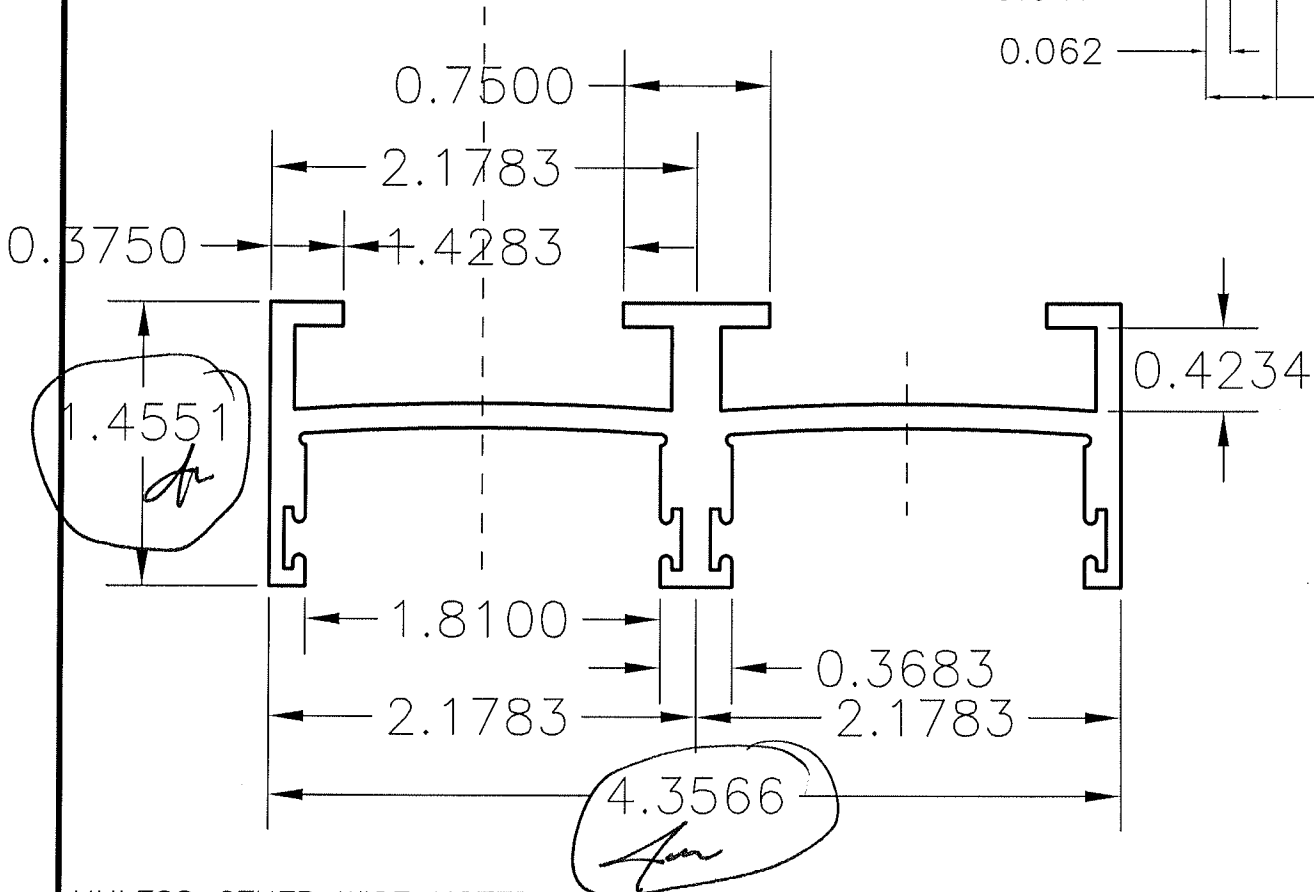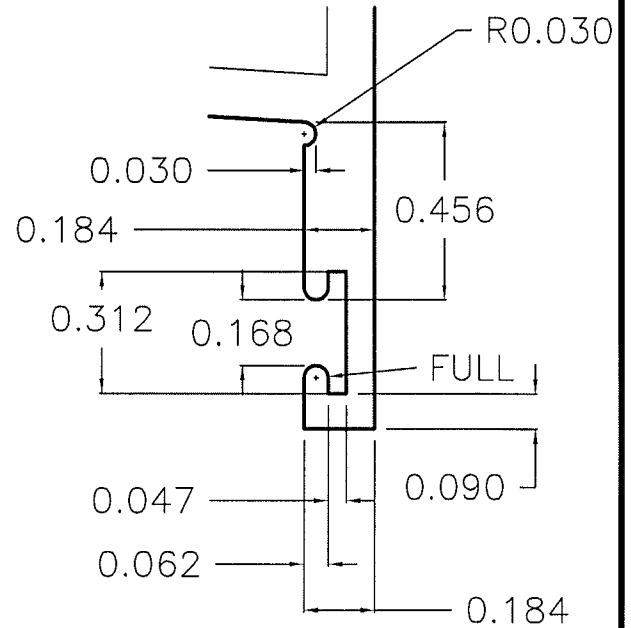

UNLESS OTHER WISE NOTED .125 TYP. WALL ALL UNMARK CORNER ARE 0.010

REVISION	CUSTOMER:		
	MAT. L 6063-T5	HOLES	* CRITICAL DIM.
	AREA 1.411	BACKER	⊗ SPECIAL TOOL
	WT. / FT 1.694	BOLSTER	DRAWN: AJ
PERI. 20.91	W/P	DATE: 7/22/10	
FACTOR 12.34	EXT. RATIO	PART NAME:	
C.C.D.	CLASS Solid	SCALE 1 : 1	
		PART #	

**PRL**  
**ALUMINUM INC.**  
 14760 DON JULIAN RD.  
 INDUSTRY CA. 91746  
 TEL. ( 877 ) 775-2586  
 PRL-ALUM  
 FAX ( 877 ) 274-8800


UNLESS OTHERWISE SPECIFIED STANDAR ALUMINUM ASSOCIATION TOLERANCES APPLY

DIE NO. **2248**



Test sample complies with these details.  
Deviations are noted.

Report# BS023.01  
Date 12/15 Tech [Signature]

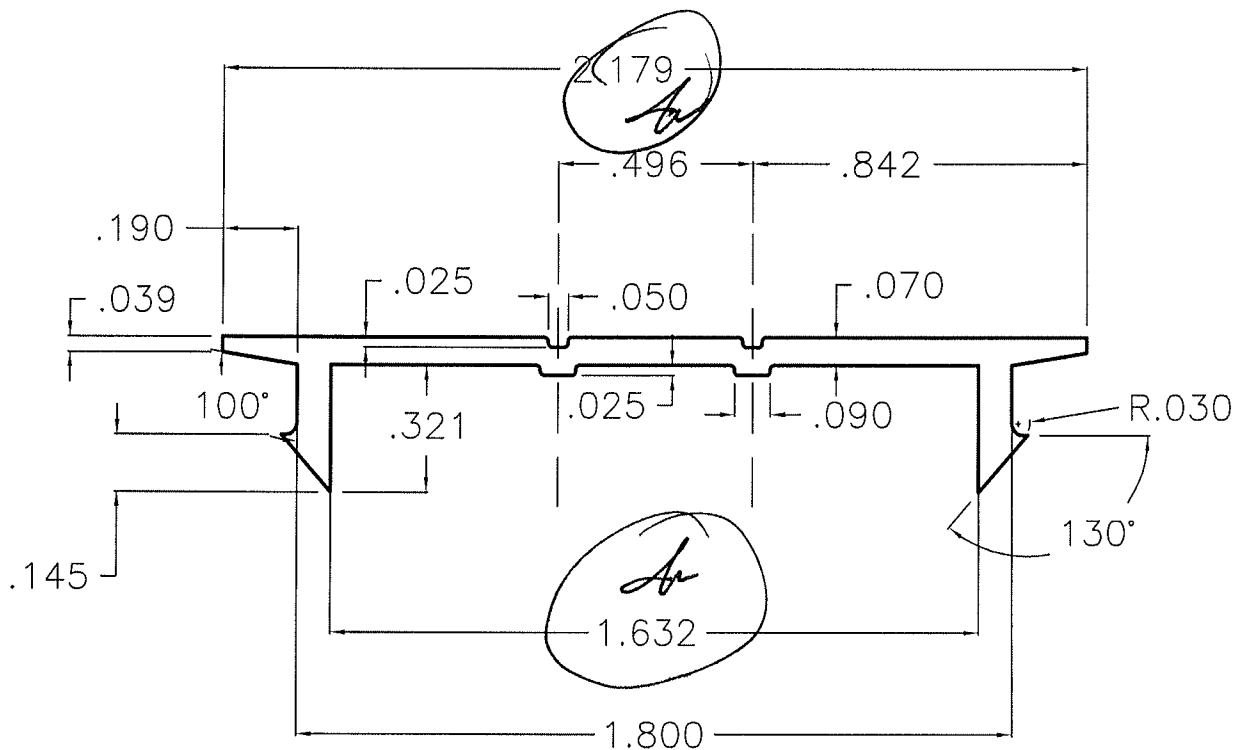

UNLESS OTHER WISE NOTED .070 TYP. WALL UNMARKED CORNERS .010

REVISION

CUSTOMER: - **PRL**

**PRL**  
**ALUMINUM INC.**


14760 DON JULIAN RD.  
INDUSTRY CA. 91746  
TEL. ( 877 ) 775-2586  
PRL-ALUM  
FAX ( 877 ) 274-8800

MAT.'L	6063-T5	HOLES	* CRITICAL DIM.
AREA	.201	BACKER	⊗ SPECIAL TOOL
WT. / FT	241	BOLSTER	
PERI.	5.87	W/P	DRAWN: <b>AJ</b>
FACTOR	24.35	EXT. RATIO	DATE: 5/24/10
C.C.D.		CLASS Solid	SCALE 1:2

PART NAME: Bottom track Cove  
PART #

UNLESS OTHERWISE SPECIFIED STANDAR ALUMINUM ASSOCIATION TOLERANCES APPLY

DIE NO. 2237

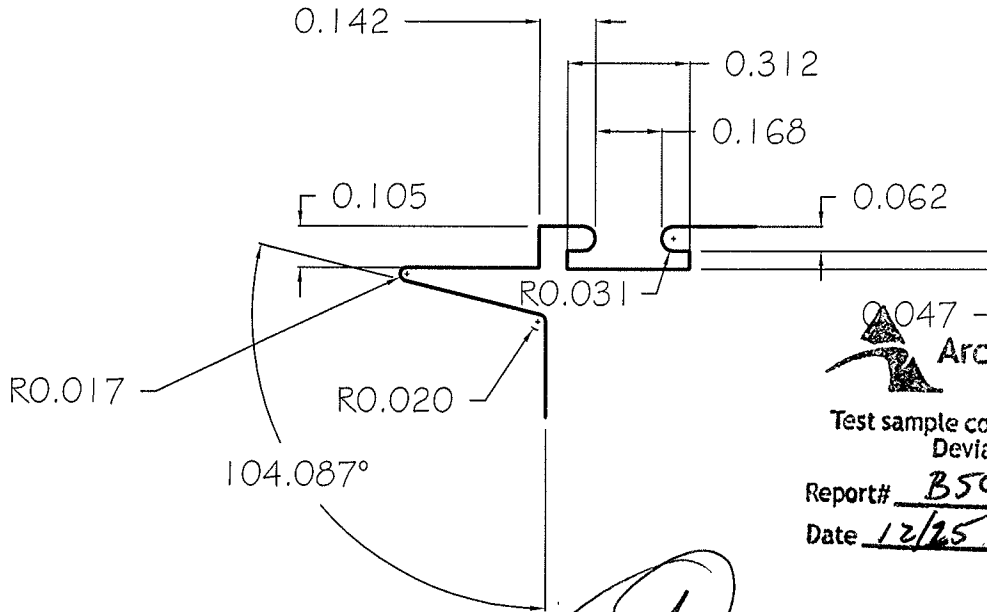


AO47  
Architectural Testing

Test sample complies with these details.  
Deviations are noted.

Report# B5023.01

Date 12/25 Tech *[Signature]*

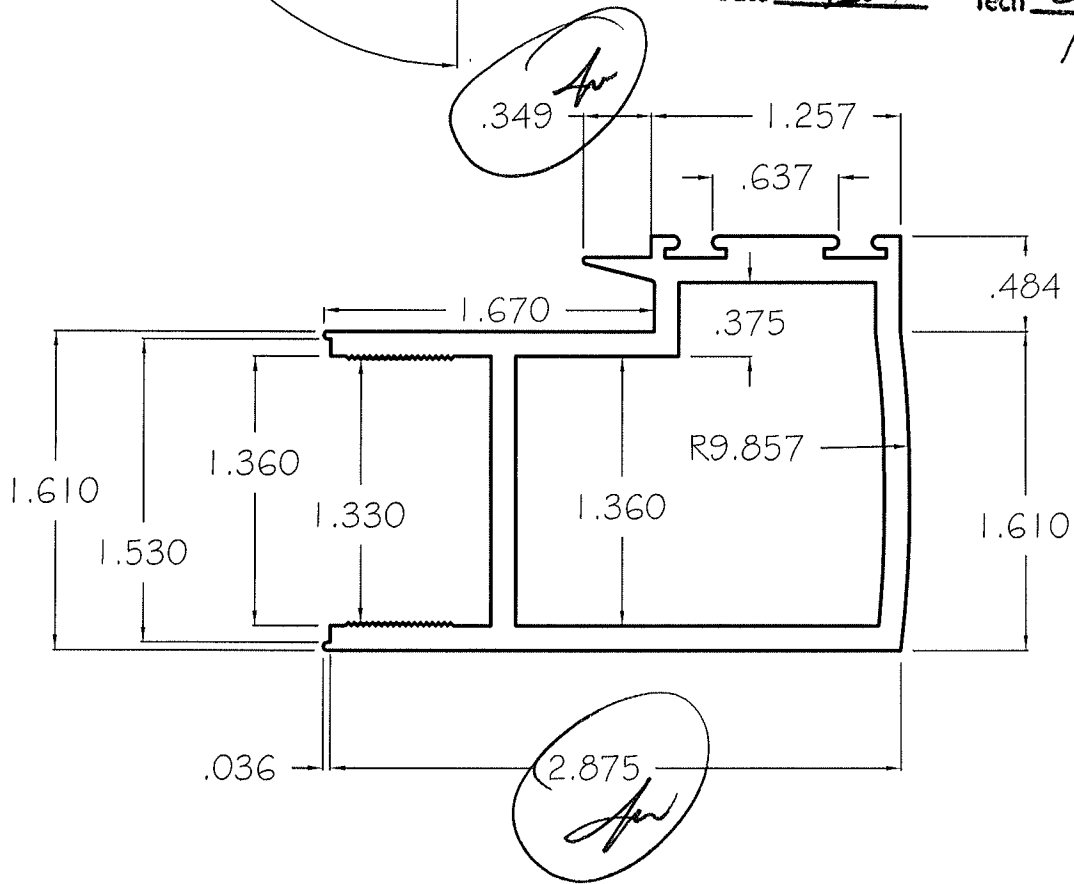

UNLESS OTHER WISE NOTED .125 TYP. WALL

UNMARKED CORNERS .010 R.

REVISION	CUSTOMER: PRL ALUMINUM INC		
MAT.'L	6063-T5	HOLES	* CRITICAL DIM.
AREA	1.277	BACKER	⊗ SPECIAL TOOL
WT. / FT	1.534	BOLSTER	DRAWN: AJ
PERI.	20.77	W/P	DATE: 4/07/10
FACTOR	13.54	EXT. RATIO	SCALE 1 : 1
C.C.D.	CLASS Hollow		

**PRL**  
ALUMINUM INC.  
14760 DON JULIAN RD.  
INDUSTRY CA. 91746  
TEL. (877) 775-2586  
PRL-ALUM  
FAX (877) 274-8800

PART NAME: Int Lock Stile  
PART #

UNLESS OTHERWISE SPECIFIED STANDAR ALUMINUM ASSOCIATION TOLERANCES APPLY



DIE NO. 2201



**Architectural Testing**

Test sample complies with these details.  
Deviations are noted.

Report# 35023.01  
Date 12/15 Tech [Signature]

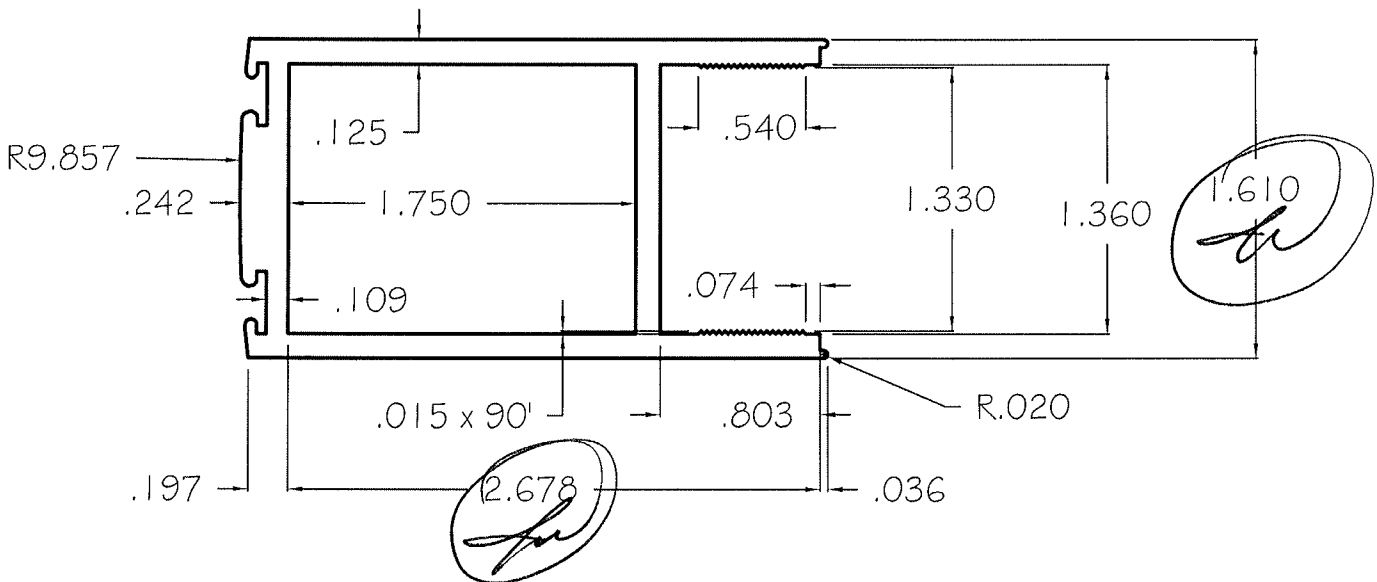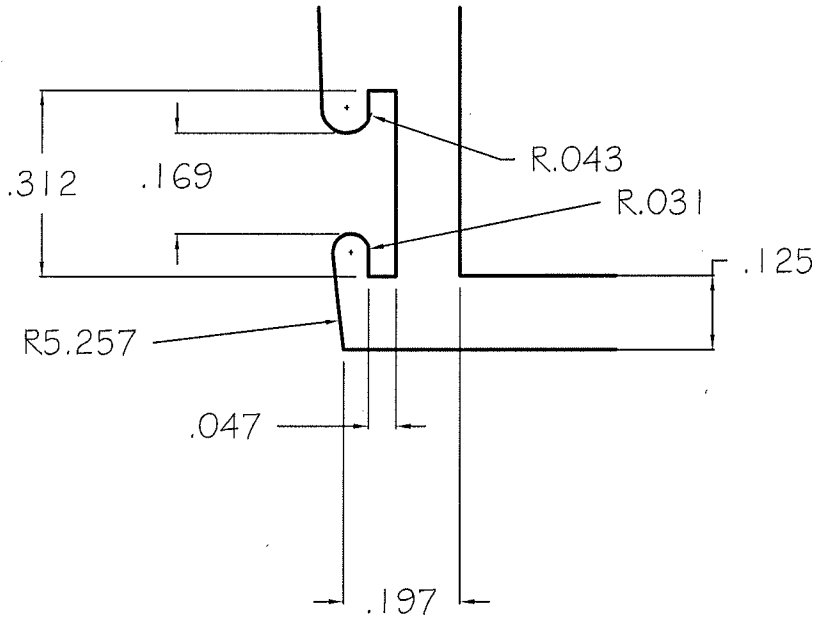

UNLESS OTHER WISE NOTED .125 TYP. WALL

ALL UNMARK CORNER ARE 0.010

REVISION	CUSTOMER:		
	Revised as of 2/11/10		
	MAT.'L 6063-T5	HOLES	* CRITICAL DIM.
	AREA 1.164	BACKER	⊗ SPECIAL TOOL
	WT. / FT 1.40	BOLSTER	
	PERI. 18.28	W/P	DRAWN: AJ
	FACTOR 13.06	EXT. RATIO	DATE: 12/8/09
	C.C.D.	CLASS Hollow	SCALE 1 : 1

**PRL**  
**ALUMINUM INC.**  
14760 DON JULIAN RD.  
INDUSTRY CA. 91746  
TEL. (877) 775-2586  
PRL-ALUM  
FAX (877) 274-8800


PART NAME:  
PART #





UNLESS OTHERWISE SPECIFIED STANDAR ALUMINUM ASSOCIATION TOLERANCES APPLY

DIE NO. 2249

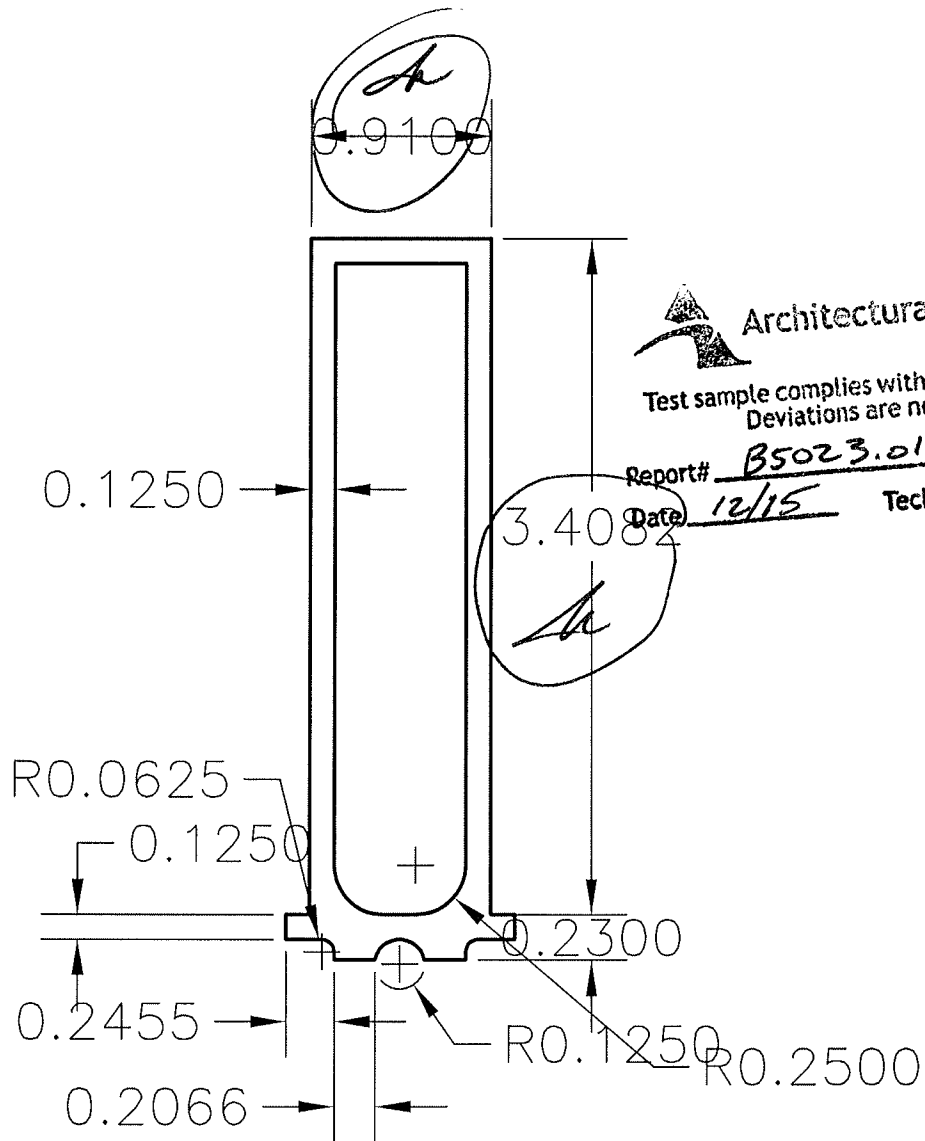

Architectural Testing


Test sample complies with these details.  
Deviations are noted.

Report# B5023.01  
Date 12/15 Tech [Signature]

UNLESS OTHER WISE NOTED .125 TYP. WALL

UNMARKED CORNERS .010

REVISION	CUSTOMER: - <b>PRL</b>		
MAT'L	6063-T5	HOLES	* CRITICAL DIM.
AREA	1.16	BACKER	⊗ SPECIAL TOOL
WT. / FT	11.39	BOLSTER	DRAWN: <b>AJ</b>
PERI.	17.30	W/P	DATE: 5/24/10
FACTOR	12.45	EXT. RATIO	SCALE 1:1
C.C.D.	CLASS	Hollow	PART #


**PRL**   
**ALUMINUM INC.**  
 14760 DON JULIAN RD.  
 INDUSTRY CA. 91746  
 TEL. ( 877 ) 775-2586  
 PRL-ALUM  
 FAX ( 877 ) 274-8800



Test sample complies with these details.  
Deviations are noted.

Report# B5023.01  
Date 12/15 Tech [Signature]

DIE NO. 2204

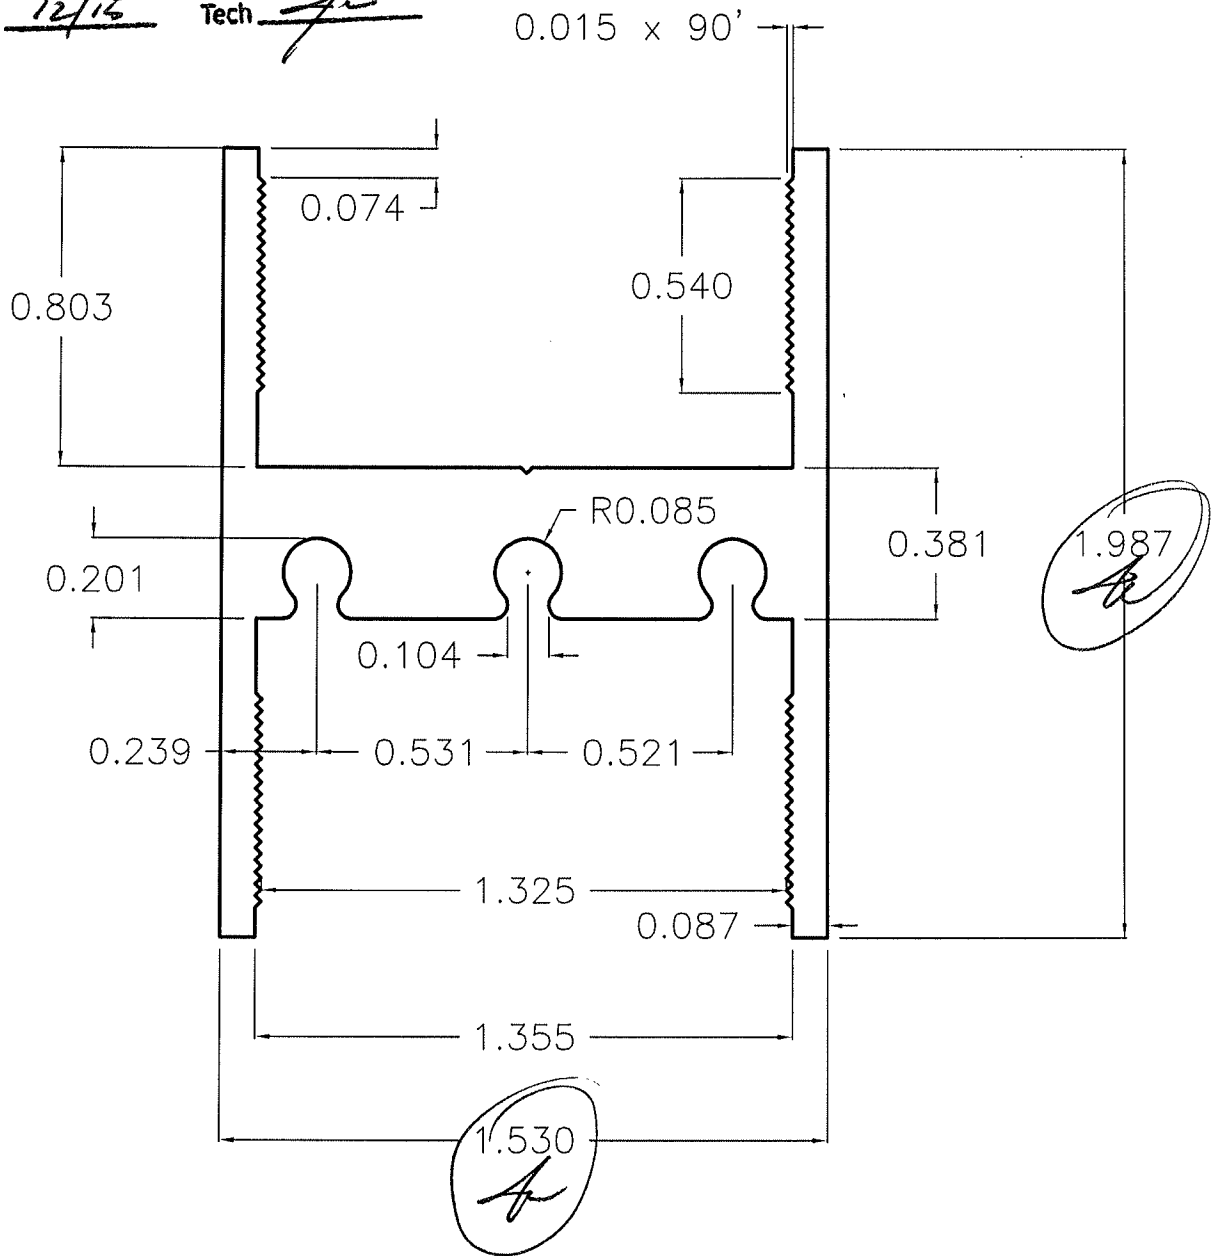

REVISION

CUSTOMER:

Revised as of 2/11/10

MAT. L 6063-T5

AREA .80

WT. / FT.96

PERI. 12.30

FACTOR 12.81

C.C.D.

HOLES

BACKER

BOLSTER

W/P

EXT. RATIO

CLASS Solid

\* CRITICAL DIM.

⊗ SPECIAL TOOL

DRAWN: AJ

DATE: 12/8/09

SCALE 2 X

**PRL**  
**ALUMINUM INC.**

14760 DON JULIAN RD.

INDUSTRY CA. 91746

TEL. ( 877 ) 775-2586

PRL-ALUM

FAX ( 877 ) 274-8800

PART NAME:


PART #



Test sample complies with these details.  
Deviations are noted.

Report# B5023 .01

Date 12/15 Tech [Signature]

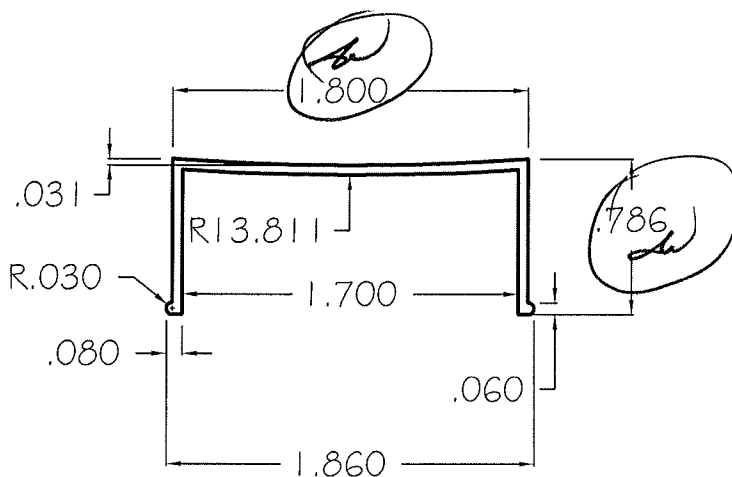

UNLESS OTHER WISE NOTED .050 TYP. WALL

ALL UNMARK CORNER ARE 0.010

REVISION	CUSTOMER:		
MAT.'L	6063-T5	HOLES	* CRITICAL DIM.
AREA	.167	BACKER	⊗ SPECIAL TOOL
WT. / FT	.20	BOLSTER	
PERI.	6.70	W/P	DRAWN: AJ
FACTOR	33.50	EXT. RATIO	DATE: 12/8/09
C.C.D.	CLASS Solid	SCALE 1 : 1	PART #

**PRL**  
**ALUMINUM INC.**  
14760 DON JULIAN RD.


INDUSTRY CA. 91746  
TEL. (877) 775-2586  
PRL-ALUM  
FAX (877) 274-8800

PART NAME:


Architectural Testing

Test sample complies with these details.  
Deviations are noted.


Report# B923-21  
Date 11/15 Tech [Signature]

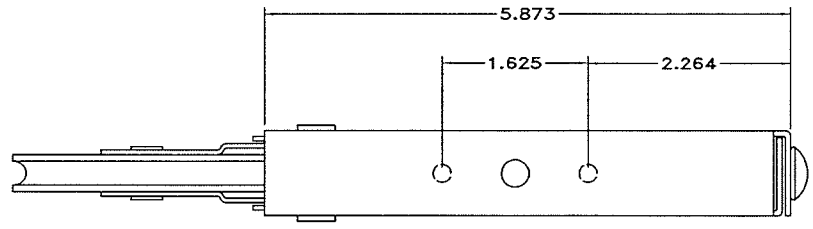


top view

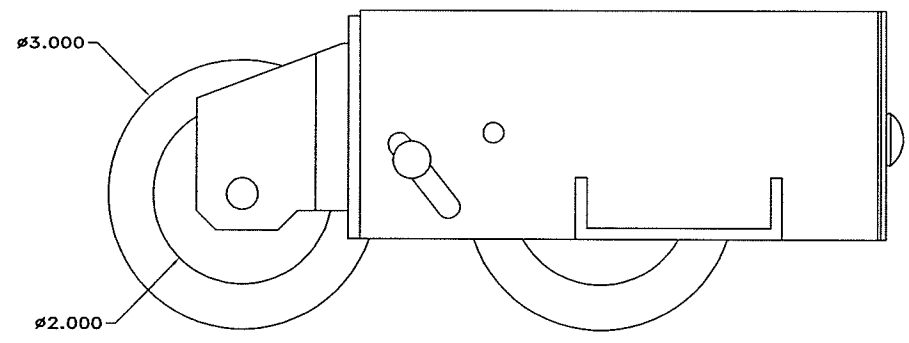

front view

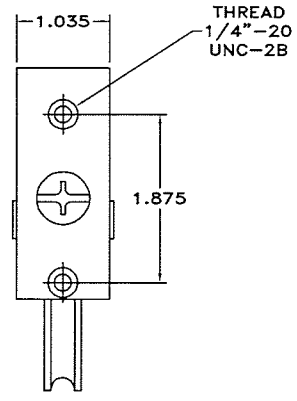

side view

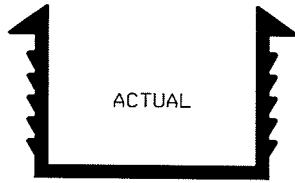

CUSTOMER APPROVAL DATE:.....BY:.....  
 RELEASE FOR:  
 QUOTATION  
 TOOLING DEVELOPMENT  
 PRODUCTION


THIS PROFILE IS DRAWN TO SPECIFICATIONS PROVIDED BY THE CUSTOMER NAMED BELOW. CUSTOMER IS SOLELY RESPONSIBLE FOR FUNCTIONING OF THE PART DEVELOPED PER THIS PRINT.




**Architectural Testing**

Test sample complies with these details.  
 Deviations are noted.

Report# B5023.01  
 Date 12/15 Tech [Signature]

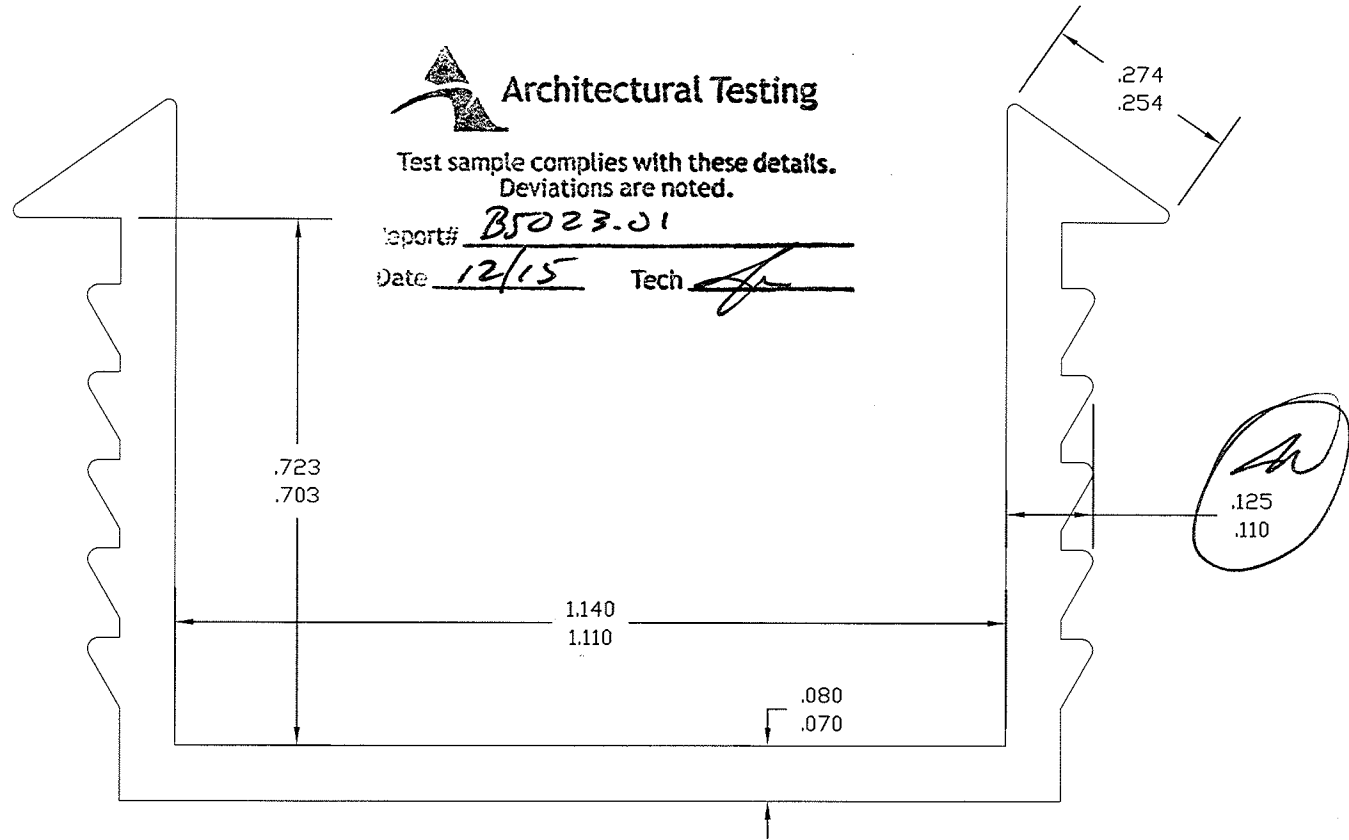

NO	DATE	BY	REVISIONS	PRINT APPROVAL	RIGID WALL (EXCEPT AS NOTED)	 <b>AMESBURY</b> <b>BANDLOCK PRODUCTS</b> <i>Reliable Resource.          Superior Solutions.</i>	1734 S. VINEYARD AVE. ONTARIO, CA 91761 USA PH:(909)947-7500 FAX:(909)930-2553
				QUALITY SUPERVISOR	FLEX WALL (EXCEPT AS NOTED)		
				ENGINEERING MANAGER	MATERIAL FPVC	DESCRIPTION: 1.125" GLAZING CHANNEL	
				COMPUTER UPDATED	TOLERANCES (EXCEPT AS NOTED) DECIMAL +/- .020 FRACTIONAL +/- 1/32 ANGULAR +/- 5°	P/N:	
						SCALE: 4X	CUSTOMER: PRL ALUMINUM
						DATE: 06/15/11	BL-4514
						DRAWN BY: S.B.	